
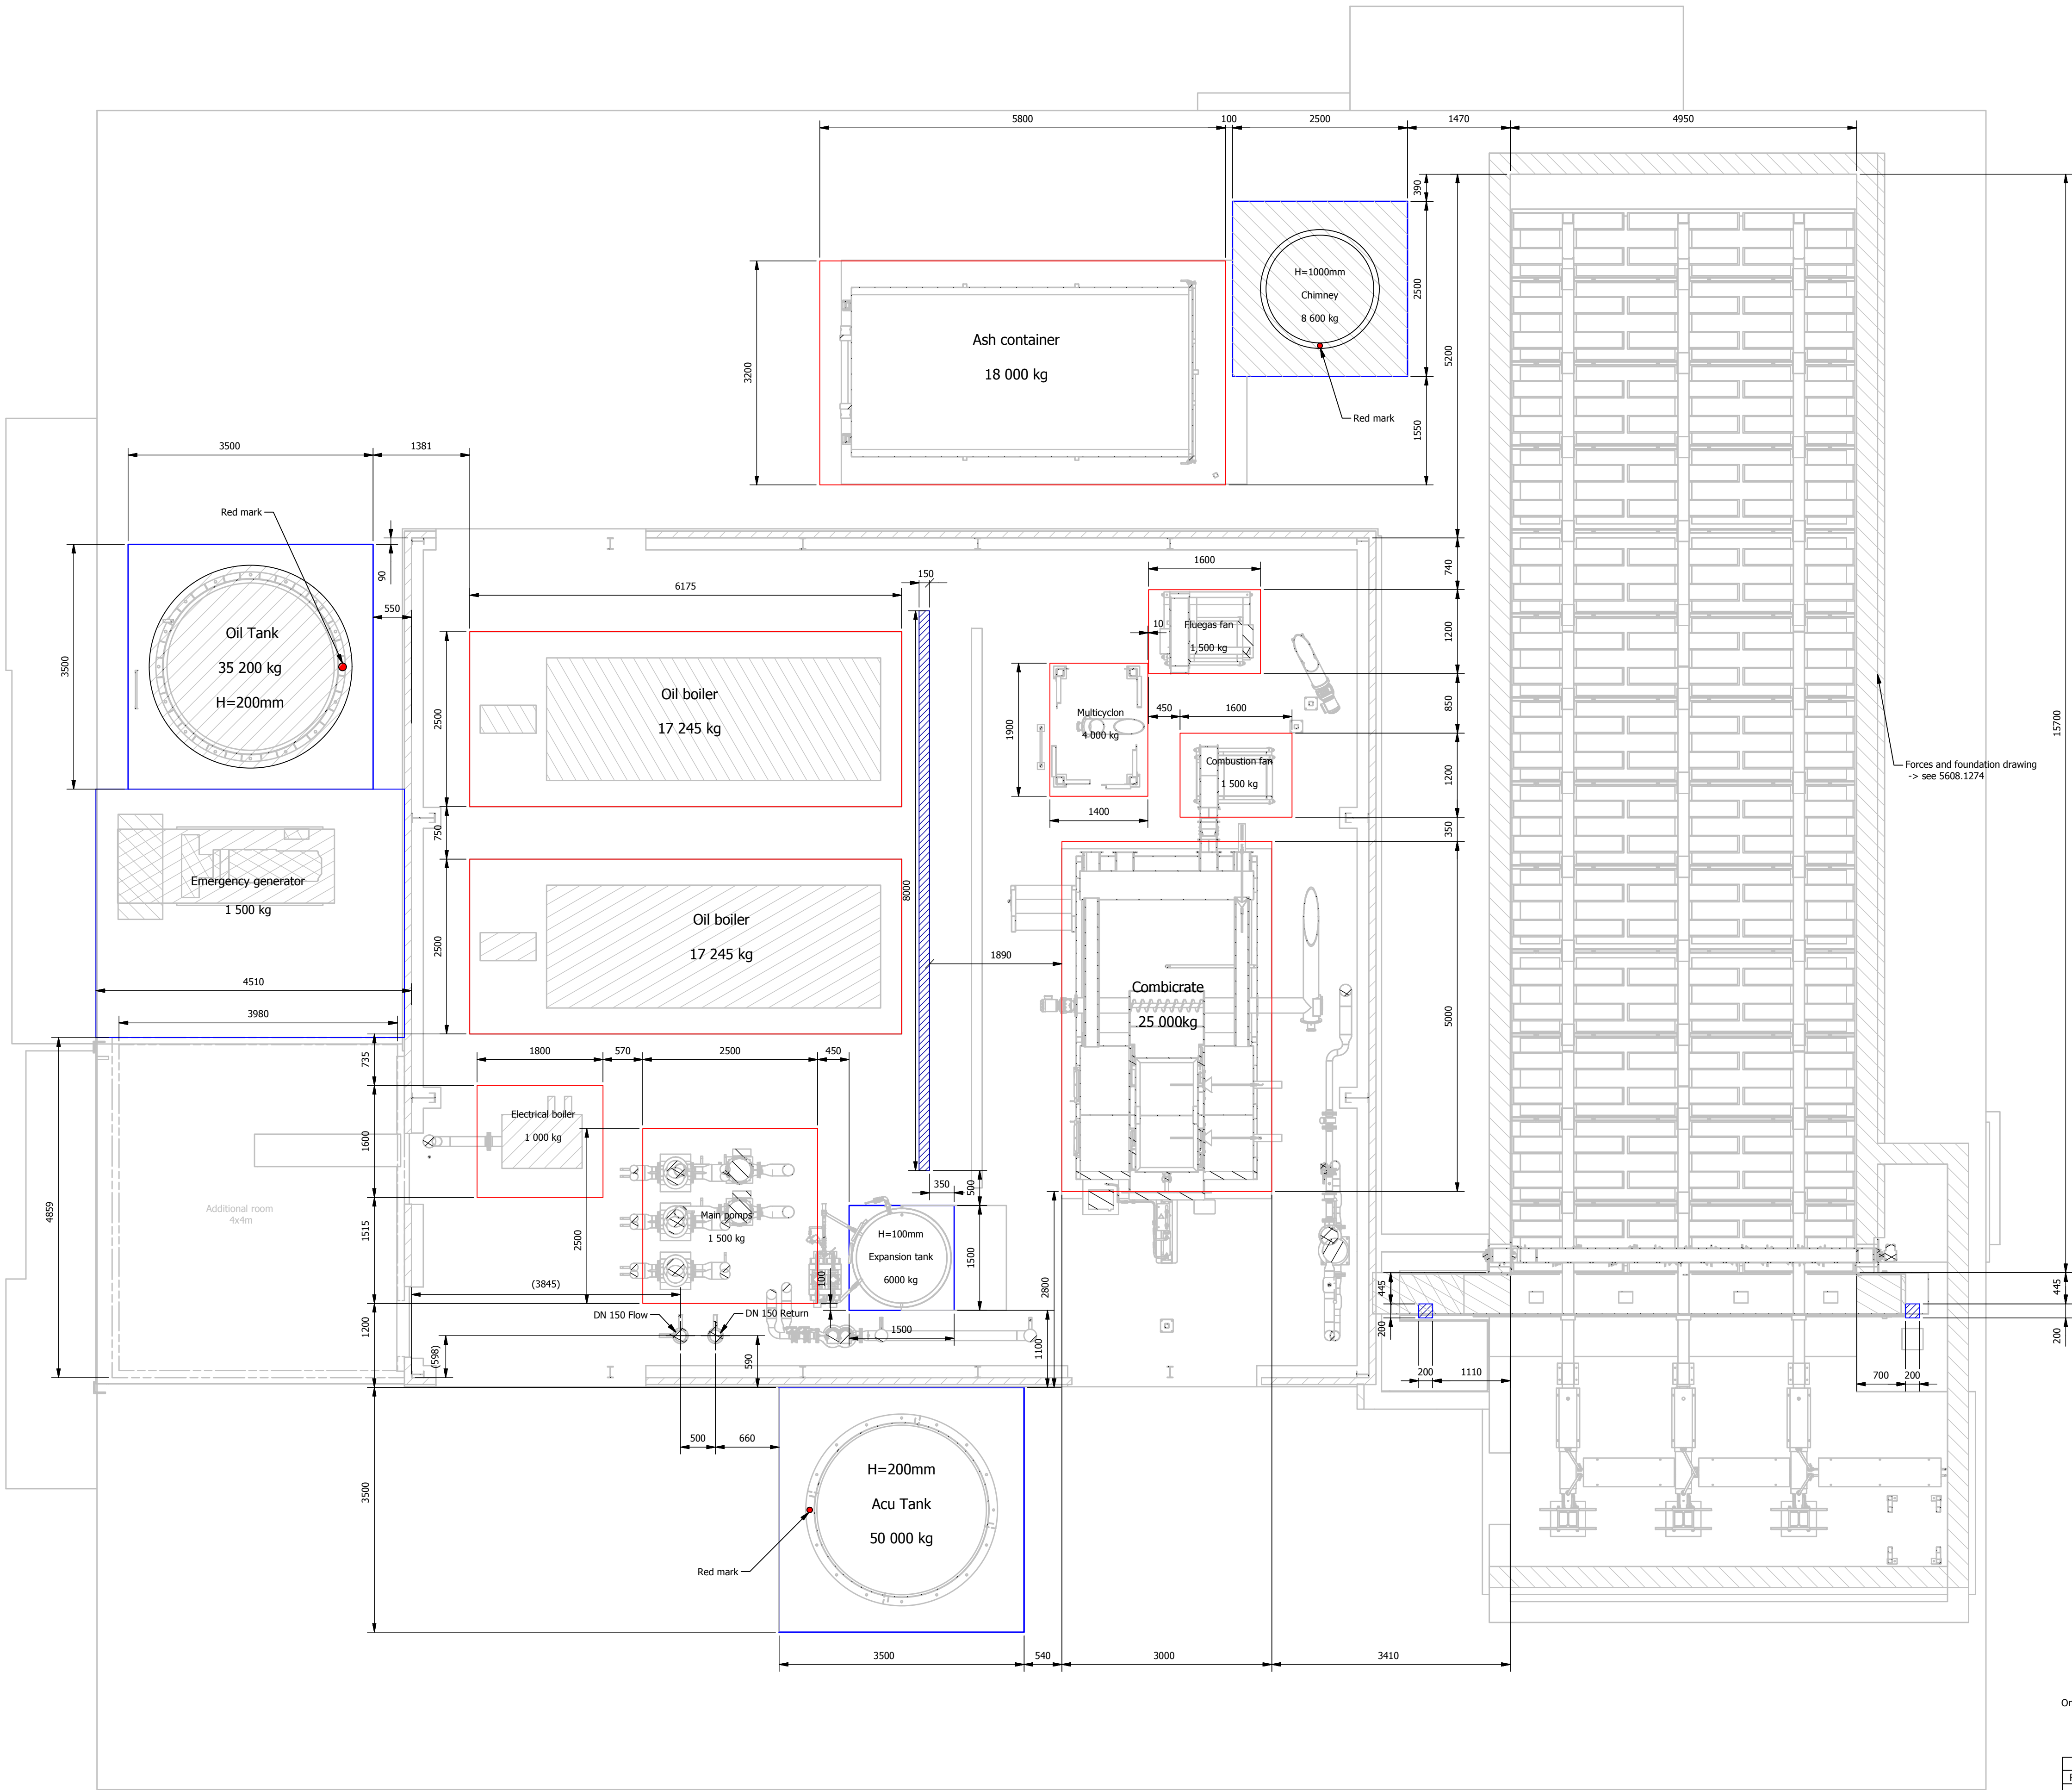


Tolerances:
If nothing else is indicated
ISO 2768-1 coarse is valid.

A-A (1 : 50)

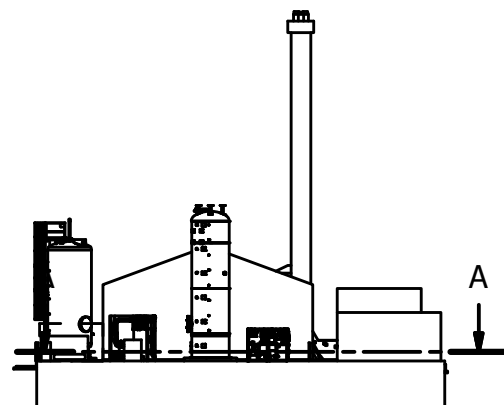

On not determined places, max point load on area of 200mm x 200mm - 600kg.

- Acu drain

REVISION HISTORY				
Revision	Revision Comments	Made by	Revision Date	Checked by
A	Changes to position of loads. Expansion tank position.	PAWDAB	06-05-2014	
B	Pistion change	PAWDAB	08-08-2014	
C	Red marks/Final positions	PAWDAB	21-08-2014	
Moelv Layout Foundations drawing		Material / Mass (kg) / N/A		Scale 1:500 Format A1
 Weiss Sp. z o.o. Ul. Kolejowa 20; 27-400 Ostrowiec Św. Tlf. +48 41 26 36 975 info@weiss-envirokraft.eu Fax. +48 41 26 36 975 www.weiss-envirokraft.eu		Created By / Date PAWDAB/2014-03-11		Rev. by / Release Date PAWDAB/2014-08-21
		Drawing no. 5608.00-2		Sheet no. 1 / 1 Rev. C



Weiss Sp. z o.o.
Ul. Kolejowa 20; 27-400 Ostrowiec Św.
Tlf. +48 41 26 36 975 info@weiss-envikraft.eu
Fax. +48 41 26 36 975 www.weiss-envikraft.eu